

TITCOMB PIT LANDFILL SOLAR PROJECT

RECORD DRAWINGS

AMESBURY, MASSACHUSETTS

MARCH 2020

SHEET NO.	SHEET TITLE
	COVER SHEET
C-001	RECORD DRAWINGS PLAN - OVERALL
C-002	RECORD DRAWING PLAN - NORTH
C-003	RECORD DRAWING PLAN - SOUTH



SCALE: 1" = 1,000'

DEVELOPER:

KEARSARGE AMESBURY, LLC
1200 SOLDIERS FIELD ROAD
SUITE 202
BOSTON, MA 02134

APPLICANT & LAND OWNER:

CITY OF AMESBURY
62 FRIEND STREET
AMESBURY, MA 01913

CIVIL ENGINEER:

TIGHE & BOND
53 SOUTHAMPTON ROAD
WESTFIELD, MA 01085

EPC

CS ENERGY
2045 LINCOLN HIGHWAY
EDISON, NJ 08817

Tighe & Bond

RECORD DRAWING


THIS RECORD DRAWING WAS PREPARED BASED ON AS-BUILT SITE PLAN PROVIDED BY CS ENERGY, LLC AND INDICATES ONLY SIGNIFICANT CHANGES MADE FROM THE DESIGN DRAWINGS DURING CONSTRUCTION.

COMPLETE SET 4 SHEETS

RECORD DRAWING

THIS RECORD DRAWING WAS PREPARED BASED ON AS-BUILT SITE PLAN PROVIDED BY CS ENERGY, LLC AND INDICATES ONLY SIGNIFICANT CHANGES MADE FROM THE DESIGN DRAWINGS DURING CONSTRUCTION.

SEE SHEET C-005

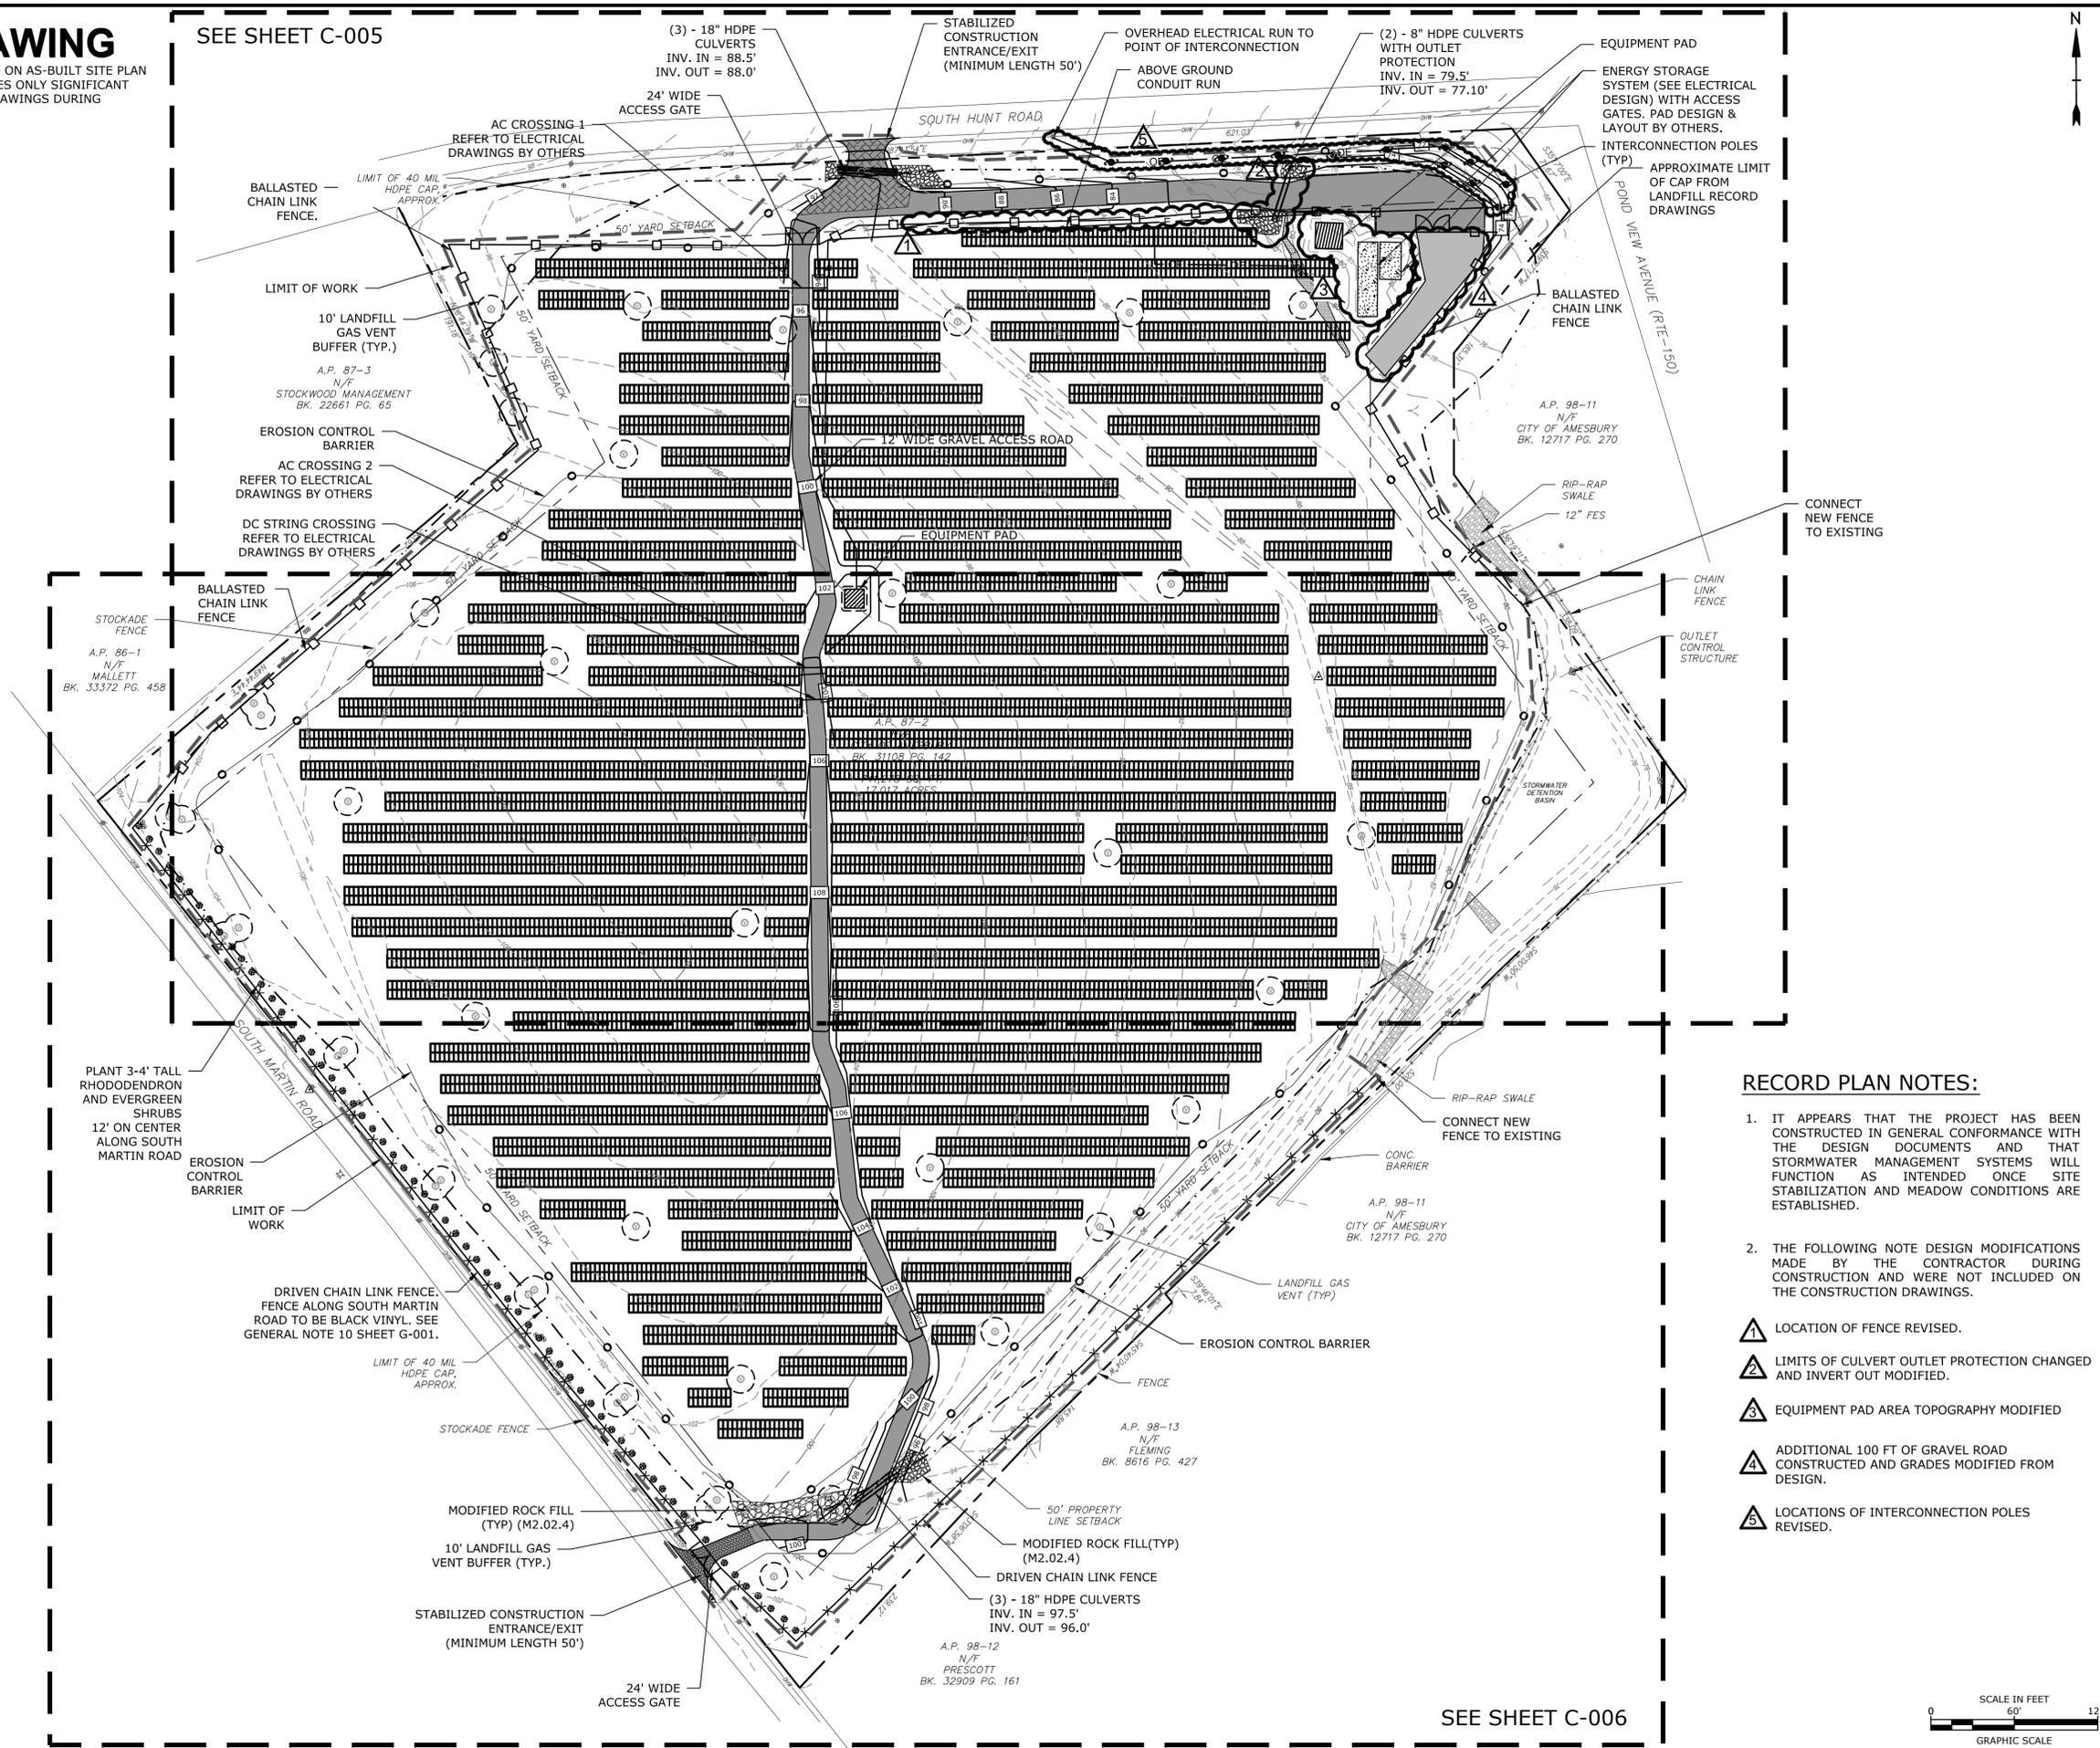

Tighe&Bond

RECORD DRAWINGS

Titcomb Pit Landfill Solar Facility

Kearsarge Amesbury, LLC

Amesbury, Massachusetts

RECORD PLAN NOTES:


- IT APPEARS THAT THE PROJECT HAS BEEN CONSTRUCTED IN GENERAL CONFORMANCE WITH THE DESIGN DOCUMENTS AND THAT STORMWATER MANAGEMENT SYSTEMS WILL FUNCTION AS INTENDED ONCE SITE STABILIZATION AND MEADOW CONDITIONS ARE ESTABLISHED.
- THE FOLLOWING NOTE DESIGN MODIFICATIONS MADE BY THE CONTRACTOR DURING CONSTRUCTION AND WERE NOT INCLUDED ON THE CONSTRUCTION DRAWINGS.
 - ⚠ LOCATION OF FENCE REVISED.
 - ⚠ LIMITS OF CULVERT OUTLET PROTECTION CHANGED AND INVERT OUT MODIFIED.
 - ⚠ EQUIPMENT PAD AREA TOPOGRAPHY MODIFIED
 - ⚠ ADDITIONAL 100 FT OF GRAVEL ROAD CONSTRUCTED AND GRADES MODIFIED FROM DESIGN.
 - ⚠ LOCATIONS OF INTERCONNECTION POLES REVISED.

VERIFY SCALE
 BAR IS 1 INCH ON ORIGINAL DRAWING
 0 1 INCH
 IF NOT ONE INCH ON THIS SHEET, ADJUST SCALES ACCORDINGLY

MARK	DATE	DESCRIPTION

PROJECT NO: K00923
 DATE: 20191105
 FILE:
 DRAWN BY: JLG / ELD
 CHECKED: BA / BSH
 APPROVED: BSH / DGM

RECORD DRAWING PLAN - OVERALL
 SCALE: 1" = 60'
SHEET C-001

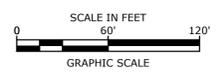

SEE SHEET C-006

Last Saved: 3/4/2020 1:31pm By: SOuturk
 Plotted On: 04/04/2020 1:31pm
 Title: C:\Drawings\Sheets\AS-Built\SitePlan - AS-Built - New.dwg
 Tighe & Bond\ENR\K00923 Kearsarge Energy Amesbury, Titcomb Pit Landfill Solar Facility

RECORD DRAWING

THIS RECORD DRAWING WAS PREPARED BASED ON AS-BUILT SITE PLAN PROVIDED BY CS ENERGY, LLC AND INDICATES ONLY SIGNIFICANT CHANGES MADE FROM THE DESIGN DRAWINGS DURING CONSTRUCTION.

RECORD DRAWINGS

Titcomb Pit Landfill Solar Facility

Kearsarge
Amesbury, LLC

Amesbury,
Massachusetts

VERIFY SCALE
BAR IS 1 INCH ON ORIGINAL DRAWING
IF NOT ONE INCH ON THIS SHEET, ADJUST SCALES ACCORDINGLY

MARK	DATE	DESCRIPTION
PROJECT NO:	K00923	
DATE:	20191105	
FILE:		
DRAWN BY:	JLG / ELD	
CHECKED:	BA / BSH	
APPROVED:	BSH / DGM	

RECORD DRAWING PLAN - NORTH

SCALE: 1" = 20'

SHEET C-002

Last Saved: 3/4/2020 11:11:14am By: Sotzurk
Plotted On: Mar 04, 2020 11:11:14am By: Sotzurk
Tighe & Bond \K00923 Kearsarge Energy Amesbury Titcomb Pit Drawings\Sheet\AS-Built\SitePlan - AS-Built - New.dwg

